THIS DRAWING IS UNPUBLISHED. RELEASED FOR PUBLICATION , .
© COPYRIGHT By – ALL RIGHTS RESERVED.

REVISIONS

P	LTR	DESCRIPTION	DATE	DWN	APVD
	G	REVISED ECR-14-010014	11NOV2014	I.T	W.H
	G1	REVISED PER ECO-17-010005	10OCT2017	R.L	S.Y

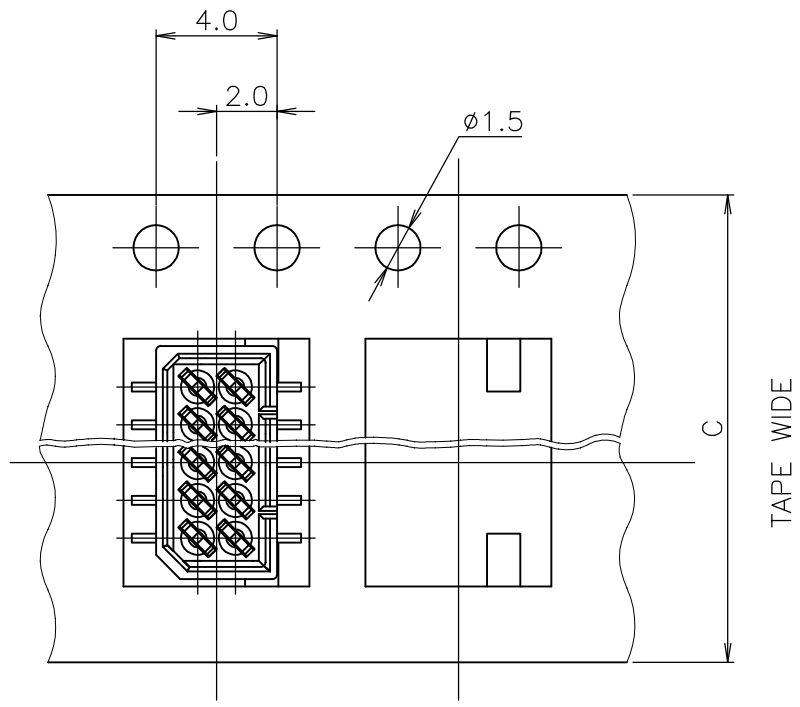

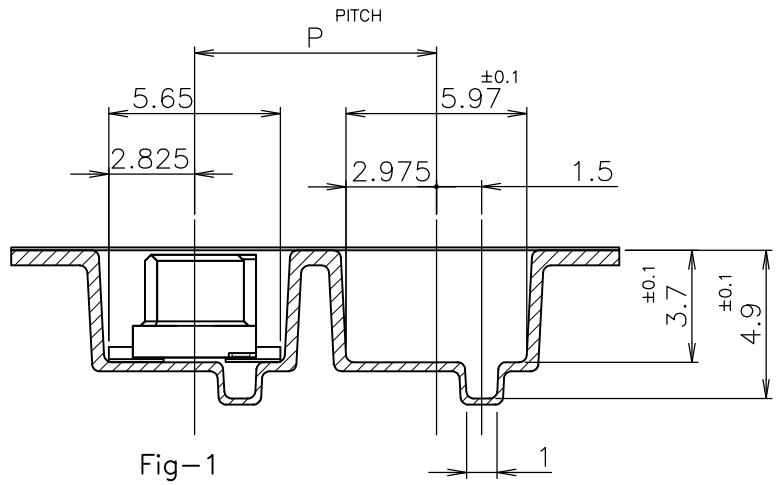

Fig-1

TOP OF REEL

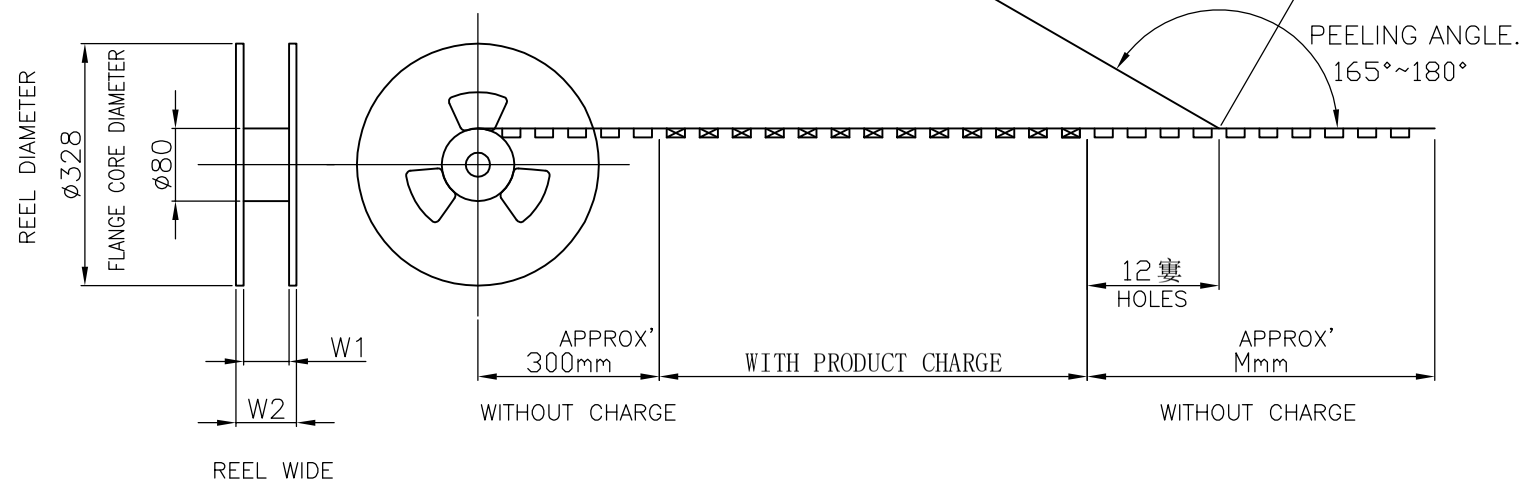

NOTES;

1. PACKING SPEC : 107-5123-1

		W_2	W_1	M	P	C	QTY/REEL	Pos.	EMBOSS TAPE P/N	CONNECTOR P/N	TAPING P/N
OBSOLETE		~~21~~	~~18~~	~~300~~	~~8~~	~~16~~	~~1500~~	~~6~~	~~1-912050-3~~	~~3-174904-6~~	~~3-175630-6~~
								10	1-720999-1	4- -0	4- -0
								12	-8	4- -2	4- -2
OBSOLETE	G1	~~29~~	~~26~~	~~600~~	~~12~~		~~1000~~	~~16~~	-9	~~4- -6~~	~~4- -6~~
OBSOLETE	G1							~~18~~	~~2- -3~~	~~4- -8~~	~~4- -8~~
OBSOLETE	G1							~~20~~	~~2- -4~~	~~5- -0~~	~~5- -0~~

WITHOUT POLYAMIDE TAPE

THIS DRAWING IS A CONTROLLED DOCUMENT.

DIMENSIONS: mm

TOLERANCES UNLESS OTHERWISE SPECIFIED:
~~0 PLC~~ ± ~~1 PLC~~ ± ~~2 PLC~~ ± ~~3 PLC~~ ± ~~4 PLC~~ ± ~~ANGLES~~ ±
10以下 : ±0.2
10を超え 30以下 : ±0.25
30を超え 100以下 : ±0.3
角度 : ±3°

MATERIAL | FINISH

DWN J.TANIGAWA 28MAY88
CHK S.KIKUCHI 30MAY88
APVD N.ONOUE 30MAY88
PRODUCT SPEC
APPLICATION SPEC
WEIGHT 0

CUSTOMER DRAWING

TE Connectivity

NAME
ON TAPING (EMBOSS)1.25 F-P CONN.
DOUBLE ROW REC HDR ASS'Y (V)
SMT WITHOUT BOSS

SIZE	CAGE CODE	DRAWING NO	RESTRICTED TO
A3	00779	C-175630	—

SCALE	SHEET	REV
NON	1 OF 2	G1